

# AUTHORIZATION TO CONDUCT NEXT FLOOD MEASURES

Pursuant to Section F of the Vermont Stream Alteration General Permit



VERMONT DEPARTMENT OF  
ENVIRONMENTAL CONSERVATION  
**WATERSHED**  
MANAGEMENT DIVISION  
RIVERS PROGRAM

## **A. Permitted Project Information:**

Project Number: **NFM-06-17-2016**

**Applicant Name:** Alan J. Menard     **Phone:** (802) 496-2913

**Mailing Address:** 269 Randell Rd., Moretown, VT 05660     **Email:** [scarz@frontiernet.net](mailto:scarz@frontiernet.net) (contractor)

**Project Location:** 269 Randell Rd., Fayston, VT (44.2381, -72.8378)

## **B. Findings:**

The Secretary of the Vermont Agency of Natural Resources (VT ANR) has determined that:

1. This project authorizes embankment stabilization of an existing revetment and removal of debris and gravel bar likely to cause avulsion.
2. The proposed activity is eligible for coverage under the VT ANR Stream Alteration General Permit.
3. The proposed activity will meet the terms and conditions of the General Permit provided:
  - a) The project will be completed and approved as shown on the plan dated 09/13/2016, and approved by the Vermont Agency of Natural Resources.

## **C. Standard Conditions:**

1. The project is proportional to the threat and conditioned to cease when the threat to life or to improved property has ended.
2. The project will not result in a threat to life, public health or safety.
3. The project will meet the standards detailed in subsection E.2.1 and E.2.2 of the General Permit.
4. The project will meet Stream Alteration Standards to the greatest extent possible.
5. A pre-construction meeting is held between the contractor, owner/applicant, and the ANR River Management Engineer.
6. The River Management Engineer is notified by phone or email when construction begins and when the project is complete. Contact information is provided on the bottom of this authorization.
7. A final construction inspection is required for any culvert and bridge related work.
8. Additional conditions: The contractor shall contact the River Management Engineer should any work within flowing water be necessary.

If there are any changes in the project plan or deviation in construction from the plan, the Permittee must notify the River Management Engineer immediately.

If the project is constructed as you have described, as shown on the above referenced approved plans and according to the above conditions, there is no reason to expect any violation of Vermont Water Quality Standards.

## **D. Authorization:**

Signed this 13<sup>th</sup> day of September, 2016

Alyssa B Schuren, Commissioner

Department of Environmental Conservation

by:


Jaron Borg, River Management Engineer

## **E. Engineer Contact Information**

Engineer Contact: Jaron Borg

Engineer Contact Phone: (802) 371-8342

Engineer Email Address: [Jaron.Borg@vermont.gov](mailto:Jaron.Borg@vermont.gov)

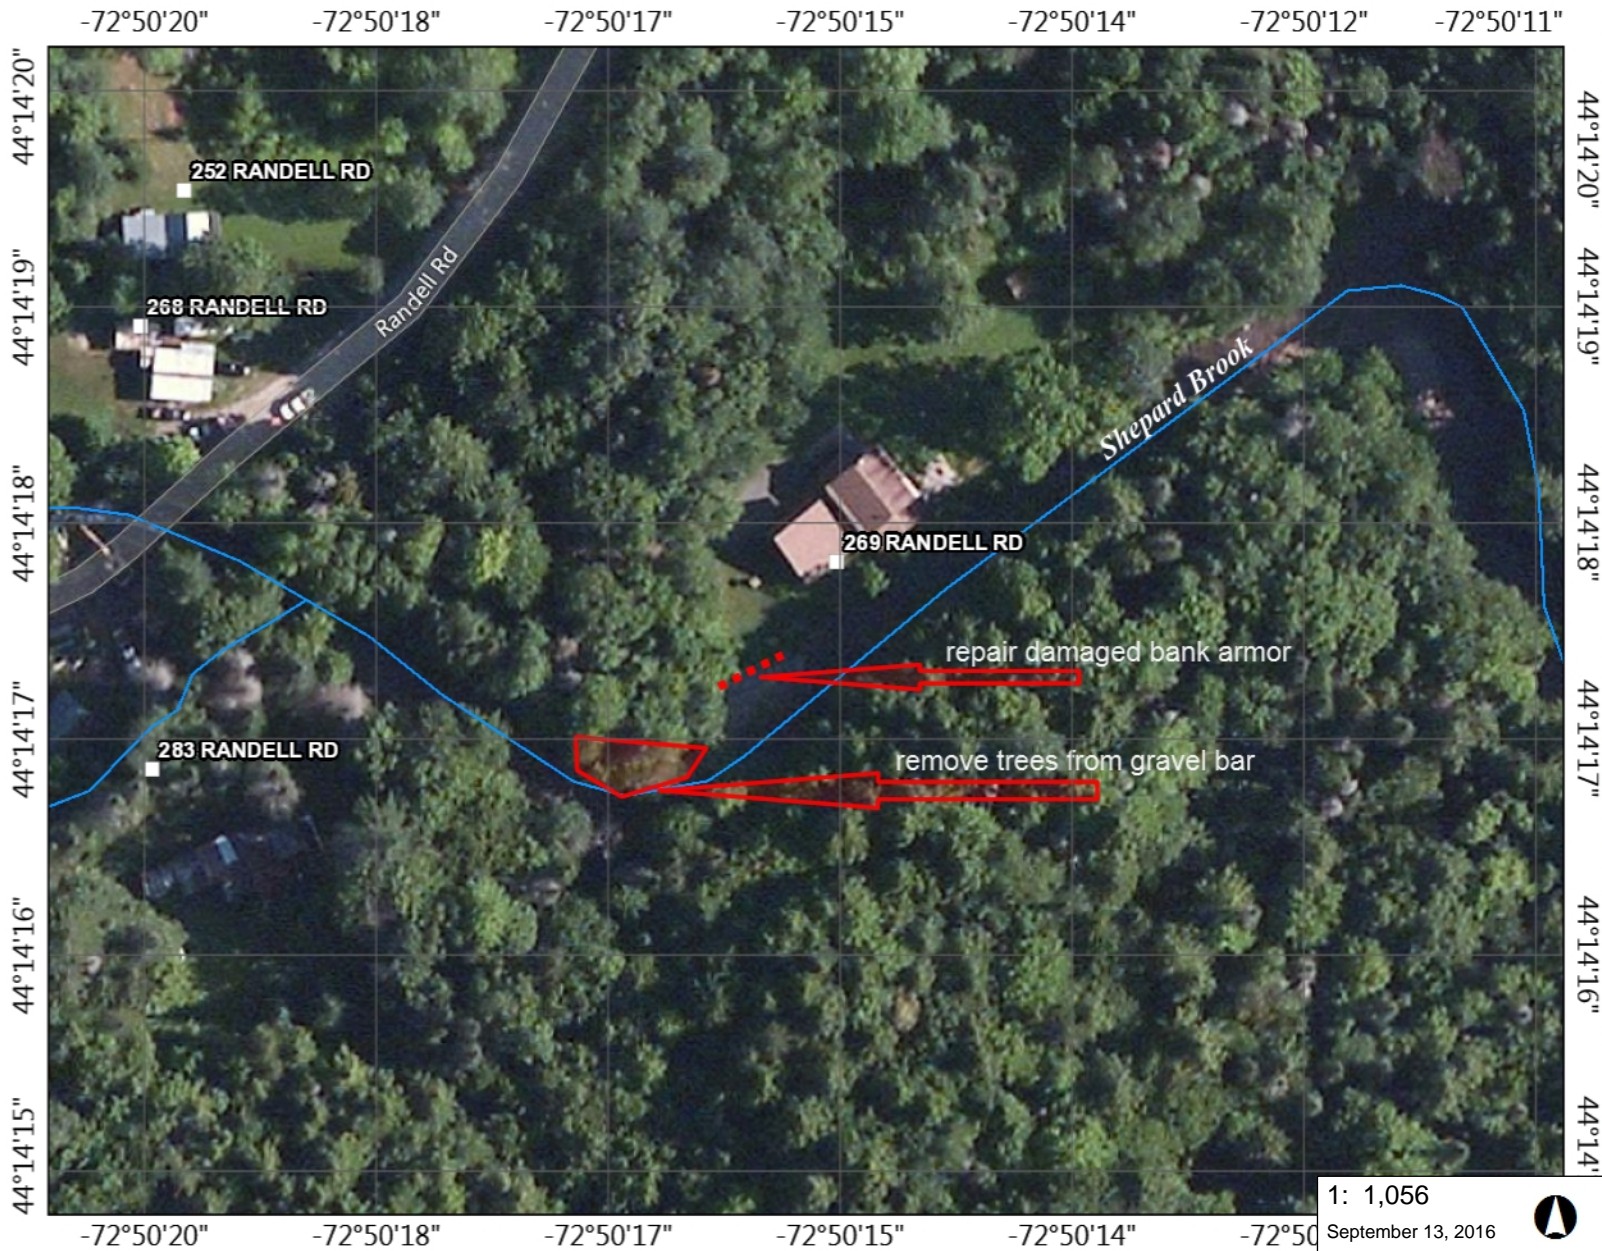

**LEGEND**

- Buildings (E911)
- Stream
- Town Boundary

**NOTES**

Alan J. Menard  
Embankment repair with type III stone and removal of tree debris to lessen channel avulsion through improved property

54.0 0 27.00 54.0 Meters

WGS\_1984\_Web\_Mercator\_Auxiliary\_Sphere 1" = 88 Ft. 1cm = 11 Meters

© Vermont Agency of Natural Resources THIS MAP IS NOT TO BE USED FOR NAVIGATION

DISCLAIMER: This map is for general reference only. Data layers that appear on this map may or may not be accurate, current, or otherwise reliable. ANR and the State of Vermont make no representations of any kind, including but not limited to, the warranties of merchantability, or fitness for a particular use, nor are any such warranties to be implied with respect to the data on this map.